


EVERSOURCE
ENERGY

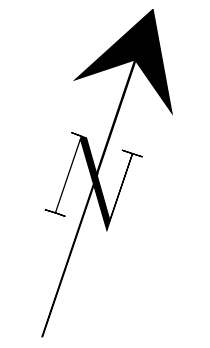

Information shown is not guaranteed and Eversource Energy assumes no responsibility. Contractors are urged to call Eversource Energy for further information at 1-800-989-0900.
by: cmlnd
P01001-01-Aug-2018

Title:

The material contained on this map shall be considered proprietary to Eversource Energy and user (which is defined as any person or entity who has received the map through sale, purchase, exchange, gift, or otherwise) shall keep it in confidence and shall not furnish or disclose it to any third party without the prior written permission of Eversource Energy.

1:240 1"=240" 480" 720"



2 JTS KEYHOLED BY FB&D 1988, 12' APART
1 JT KEYHOLED BY FB&D 1996

1 DEMO

14 JTS KEYHOLED BY FB&D 12' APART, 1998

SKETCHED LOCATION

GREENWOOD HILL ST.

W. MAIN ST.

MAIN ST.

PROVOST PLACE

CLINTON AVE.

SKETCHED LOCATION

SKETCHED LOCATION

PL LP 1999 17

P1826

P1890

P1825" CI LP

P2020

21917

P2020

AT8NSTM014

P343M

P2024

OP1715-NWK-20091011

P516

